


## MERCER ISLAND SEWER DISTRICT

## SIDE SEWER PLAT

PERMIT No. 1447

Owner HENRY H IRANGS Address 3421 72ND AVE SE Contractor DENNIS CROW CO.  
 Date Permit Issued 7-11-1961 Date Job Completed and Accepted 7-28-61 By Dunningham

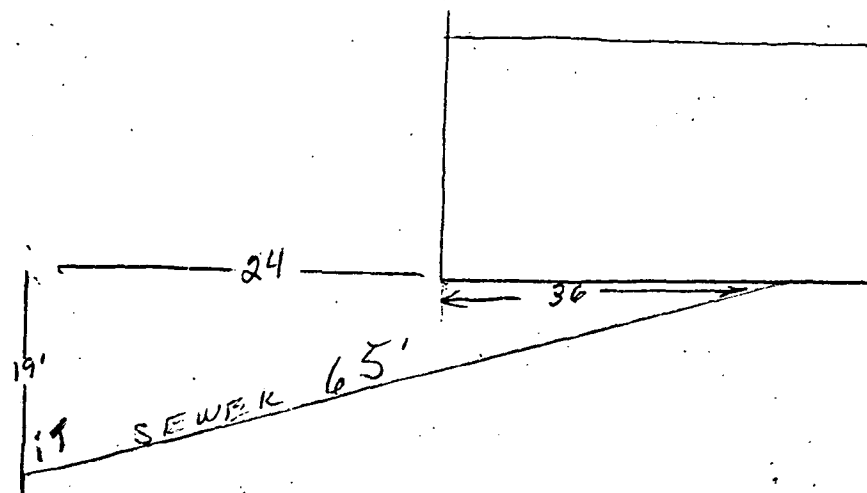

~~72 SE~~

1. Commercial or Domestic \_\_\_\_\_ Joint \_\_\_\_\_
2. Dist. from property line to sewer main \_\_\_\_\_
3. Dist. from house bldg. line to property line \_\_\_\_\_
4. Min. grade from main to property line \_\_\_\_\_ From property line \_\_\_\_\_
5. Dist. of M. H. No. \_\_\_\_\_ to Wye \_\_\_\_\_
6. Depth of sewer main to wye \_\_\_\_\_
7. Basement \_\_\_\_\_ Basement connection \_\_\_\_\_
8. Depth of pipe at house connection \_\_\_\_\_
9. Type of pipe \_\_\_\_\_ Size of pipe \_\_\_\_\_
10. Remarks \_\_\_\_\_

## COMMERCIAL ONLY

1. Name \_\_\_\_\_
2. Type \_\_\_\_\_
3. Frontage \_\_\_\_\_
4. No. of Floors \_\_\_\_\_
5. Remarks \_\_\_\_\_

PERMIT No. 1447

Date 7/12/61Permit No. Issued 1447

MERCER ISLAND SEWER DISTRICT  
APPLICATION FOR SIDE SEWER PERMIT

The undersigned hereby applies for permission to construct a side sewer for the type structure as indicated and situated on the following described property:

Type of Structure INSTALLATION OF SIDE SEWER  
(Residence, Apt., Business, etc.)  
Address of Property 3421 72ND AVE SE  
Property Legal Description E 1/2 of LOT 44 in the Part 50 & 52  
Block 2 White Birch Lot Add to East Seattle Extension  
E 12 1/2 of said lot 52 in the same extension King County Rec. For

The undersigned hereby agrees to construct the side sewer as above applied for subject to the following stipulations:

1. That all regulations and requirements set forth by Resolution No. 193, as amended, of the Mercer Island Sewer District, be complied with fully and completely. Resolution No. 193, as amended, is, by this reference, included in its entirety as a part of this side-sewer permit application and the issuance of this permit and acceptance by the Owner, or his agent, will be construed as prima facie evidence that the Owner, or his agent, has read same and agrees to its terms and stipulations in their entirety.

2. The Owner hereby agrees to maintain the side sewer constructed under this permit in accordance with the rules and regulations of the Mercer Island Sewer District and, further, will permit access with entry by authorized representatives of the Mercer Island Sewer District on the property described in this permit at any reasonable time for the purpose of inspection for compliance with all Sewer District regulations.

3. The Owner is hereby expressly notified that the Mercer Island Sewer District sewerage system is a sanitary sewer system and he agrees that he will not at any time connect storm water drainage from any source to the District's system; this includes, but is not limited to, the following:

- (a) Roof Downspouts
- (b) Building Footing Drains
- (c) Springs on the Property
- (d) Any Outside Ground or Surface Water Drains

4. The Owner and his Contractor hereby agree to accept full responsibility, and to hold Mercer Island Sewer District harmless for any liability, damage and/or costs which may accrue from prosecution of the side-sewer work under this permit.

5. The Owner and/or his Contractor hereby agree to safeguard the work done under this permit in such a manner as to prevent injury and/or damage to the public. Such precautions shall include the employment of all necessary ditch safeguards such as lanterns, barricades and safe access or egress through the working area.

6. The Owner and his Contractor agree that all street cleanup and road restoration will be made to the satisfaction of the governing authority, i.e., City, County, or State Highway, etc.

7. The Owner and Contractor agree to obtain, at no cost or liability to the District, any other permits for construction work to be accomplished under this permit.

OWNER'S NAME Henry L. Baugh OWNER'S SIGNATURE Henry L. Baugh  
(Or AUTHORIZED AGENT)

SIDE SEWER CONTRACTOR'S NAME (If any): Dennis Crow Co

SIGNATURE Dennis Crow

(For Use of Sewer District Only)

Type of Building and Use Residence  
Single Family Residence - \$ 35.00 \$ 35.00  
Multiple Family Residence, Apt., or  
Trailer Court - X \$ 35.00 \$ \_\_\_\_\_  
No. of units \_\_\_\_\_  
Commercial Buildings, Schools,  
Churches, etc. X \$ 0.01 \$ 35.00 \$ \_\_\_\_\_  
No. of Sq. Ft. \_\_\_\_\_ (Not to exceed \$100.00  
per bldg.)

Other - 35.00 \$ \_\_\_\_\_  
FEE PAID 35.00 Received By Reddon  
Mercer Island Sewer District